

NARRATIVE:

--THIS SURVEY WAS ACCOMPLISHED AT THE REQUEST OF WEYERHAEUSER COMPANY TO MARK THE BOUNDARY LINES SHOWN AS HATCHED IN SECTION 18 TOWNSHIP 4 NORTH, RANGE 3 WEST OF THE WILLAMETTE MERIDIAN.

--THE BASIS OF BEARINGS IS OREGON COORDINATE REFERENCE SYSTEM COLUMBIA RIVER WEST ZONE, NAD83 (2011) EPOCH 2010.00. DISTANCES SHOWN ARE GROUND DISTANCES.

--FOR CONTROL I HELD THE MONUMENTS AS NOTED IN THE MONUMENT NOTES.

--ALL REFERENCES WERE MEASURED WITH A HAND COMPASS SET AT DECLINATION 16° EAST AND A STEEL TAPE. ALL NEW BEARING TREES WERE MEASURED TO THE HEAD OF A 60D SPIKE SET IN THE BASE BLAZE BETWEEN THE "B" AND THE "T". BEARING TREE TAGS WERE PLACED AT SHOULDER HEIGHT ABOVE THE BLAZES.



--BOUNDARY LINES SHOWN AS HATCHED WERE MARKED WITH RED AND WHITE RIBBON ON LINE. TREES ON WEYERHAEUSER PROPERTY WITHIN 10' OF THE BOUNDARY LINE WERE MARKED WITH QUARTER BLAZES AT CHEST HEIGHT FACING TOWARDS THE BOUNDARY LINE. TREES LOCATED DIRECTLY ON LINE WERE MARKED WITH TWO BLAZES AT CHEST HEIGHT AND, ON THE BOUNDARY LINE ON BOTH SIDES OF THE TREES. 1/2 X 6' FIBERGLASS POSTS WERE SET ON LINE AT 150' MAXIMUM INTERVALS.

MONUMENT NOTES:

[3]
SECTION CORNER COMMON TO SECTIONS 17, 18, 19 & 20
FOUND 2 1/2" IRON PIPE WITH A 3 1/4" BLM BRASS DISC PER
1963 BLM SURVEY
REFERENCES FOUND:
A 10" ALDER N 46° W 29.8 FEET TO SPIKE, WITH SCRIBE
A 20" ROTTED FIR STUMP N 46° W 35.8 FEET TO
A 31" FIR N 35° E 19.3 FEET TO HEALED FACE
A 16" FIR S 46° E 13.8 FEET TO CENTER
A 30" FIR S 45° W 1.4' TO HEALED FACE

[26]
EAST 1/16 COMMON TO SECTIONS 18 AND 19
FOUND 2 1/2" IRON PIPE WITH A 3 1/4" BLM BRASS DISC PER
1972 BLM SURVEY
REFERENCES FOUND:
A T POST BEARS NORTH 1.4 FEET
A 22" FIR STUMP S 31° W 9.5 FEET TO HEALED FACE
A 25" FIR STUMP N 36° E 18.2 FEET TO HEALED FACE
A 22" FIR S 60° E 31.0 FEET TO HEALED FACE

[73]
1/4 CORNER COMMON TO SECTIONS 18 AND 17
FOUND 2 1/2" IRON PIPE WITH A 3 1/4" BLM BRASS DISC PER
1984 BLM SURVEY
REFERENCES FOUND:
A 30" FIR STUMP N 30° W 5.2', AXE MARKS VISIBLE
A ROTTED FIR STUMP N 60° E 25.1'
A 15" FIR STUMP N 11° W 30.4'
A 25" FIR N 83° E 49.80 FEET TO HEALED FACE
A 1" IRON PIPE S 50°10'13" W 53.79'
REFERENCE ADDED:
A 24" FIR N 35° E 7.82 FEET TO SPIKE, SCRIBED
A WHITE FIBERGLASS POST N 0.1'

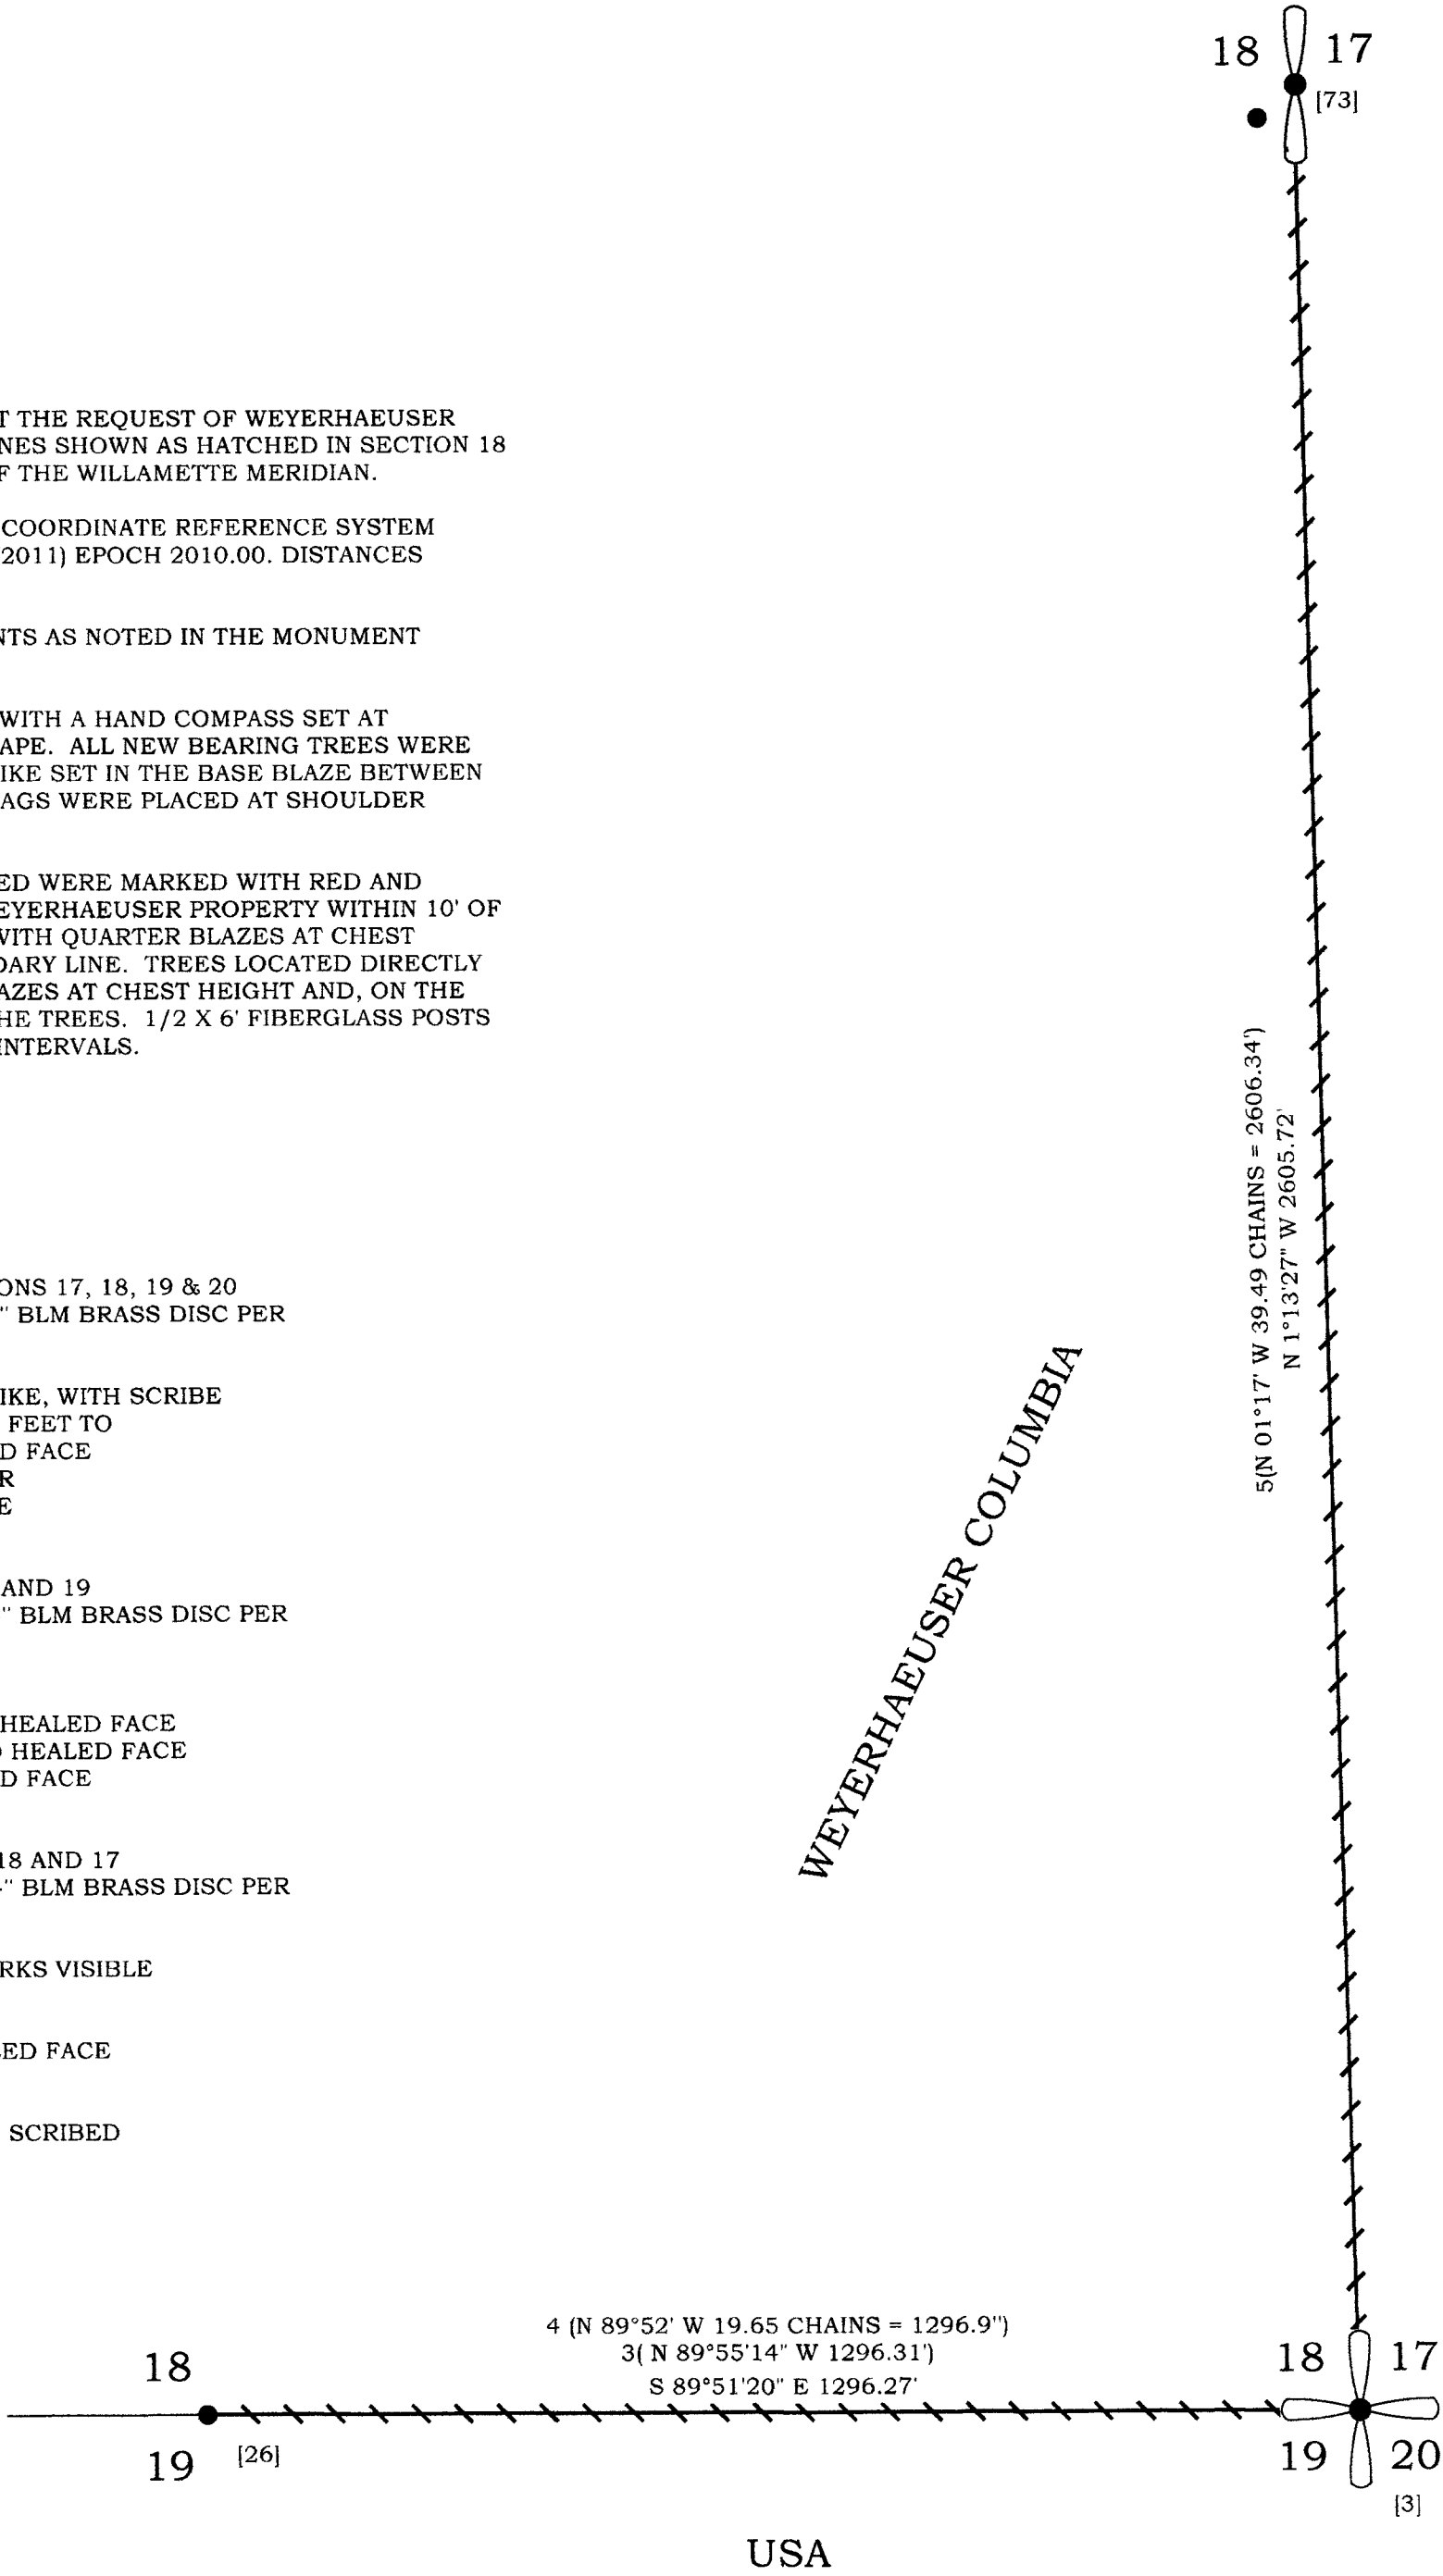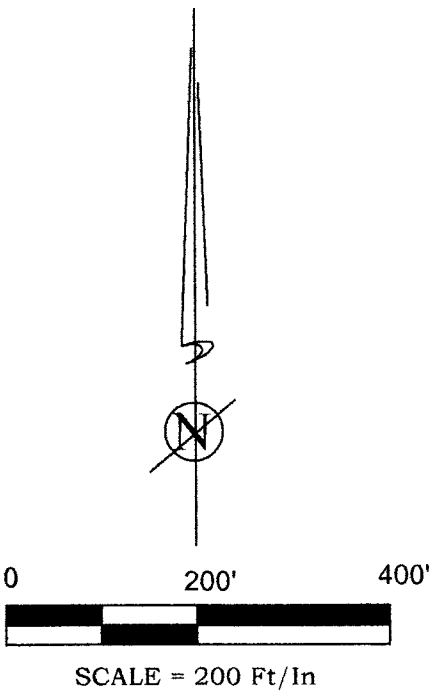

LEGEND

- FOUND MONUMENT AS NOTED
- [X] MONUMENT POINT NO
- () RECORD SURVEY DATA
- SN SURVEY NUMBER, COLUMBIA COUNTY SURVEY RECORDS

REFERENCES:

- SURVEYS
1 = CS NO. 2348
2 = CS NO. 3331
3 = CS NO. 5831
4 = 1972 BLM SURVEY
5 = 1984 BLM SURVEY

REGISTERED
PROFESSIONAL
LAND SURVEYOR

OREGON
JANUARY 19, 1993
DONALD D WALLACE, JR
2601
RENEWES 6/30/26

K.L.S. SURVEYING INC.
1224 ALDER STREET
VERNONIA, OREGON 97064
(503) 429-6115

RECORD OF SURVEY FOR
WEYERHAEUSER COMPANY
IN THE SE 1/4 OF SECTION 18,
T4N, R3W, W.M.,
COLUMBIA COUNTY, OREGON
JULY 15, 2024

DRAWN BY: DDW
FIELD: SWMJR/BTD
EQUIPMENT: NOMAD/NIKON
JOB No. 24-221
DRAWING NAME: 24-221 ROS
REVISED: 8-30-2024