FILED: 02-05-2025


CS# 7245



FOR

WEYERHAEUSER COMPANY

LOCATED IN THE NORTHEAST 1/4 OF SECTION 31, OF TOWNSHIP 5 NORTH, RANGE 3 WEST, W.M. COLUMBIA COUNTY, OREGON

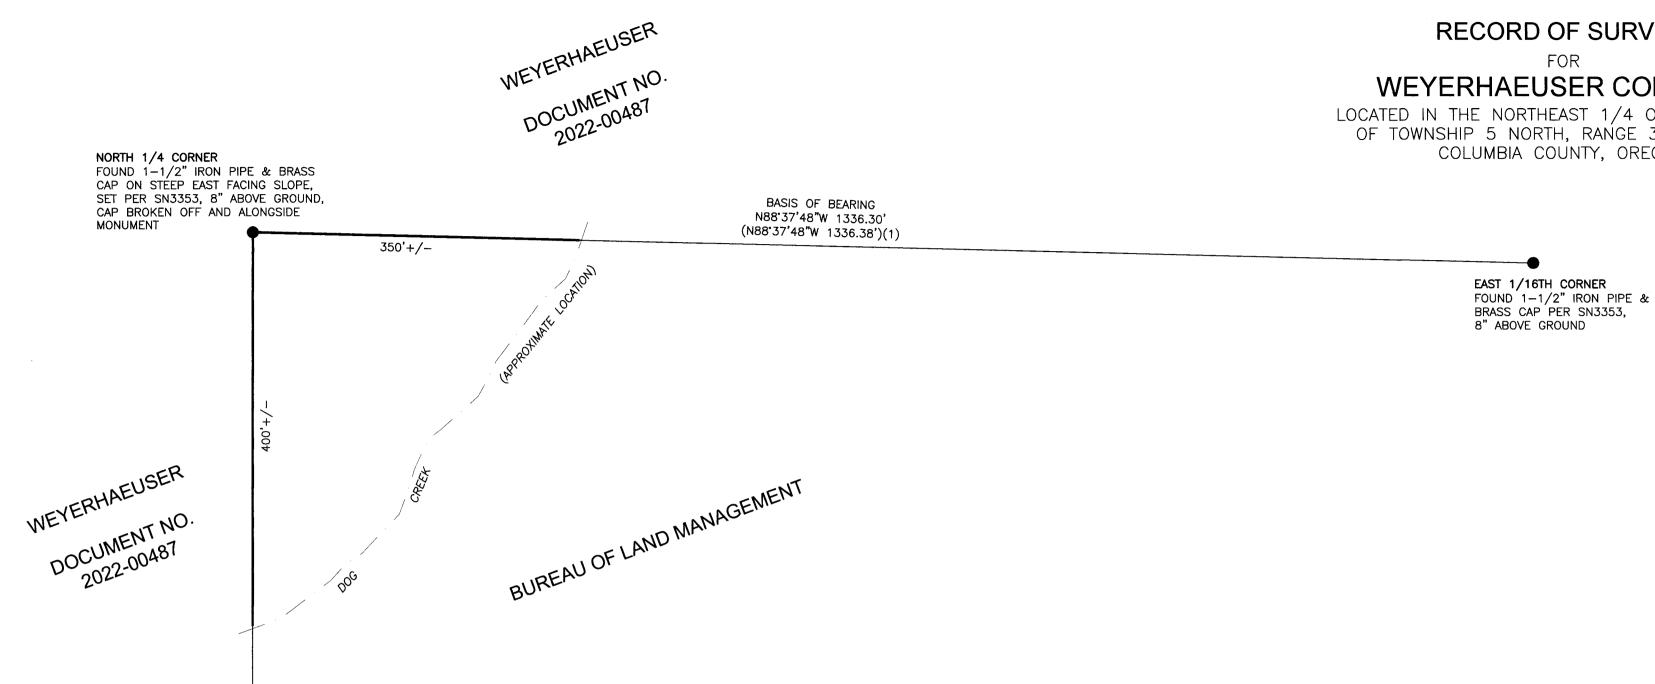



SCALE 1" = 100 Feet

NARRATIVE.
THE PURPOSE OF THIS SURVEY WAS TO MARK A PORTION OF THE SOUTH BOUNDARY OF SECTION 30, T5N R3W, AND A PORTION OF THE NORTH—SOUTH CENTERLINE OF SECTION 31, T5N R3W, AS REQUESTED BY WEYERHAUESER COMPANY. THE PORTIONS MARKED WERE LIMITED TO THOSE LYING NORTH AND WEST OF

THE BOUNDARIES WERE CONTROLLED BY FOUND MONUMENTS THAT WERE ESTABLISHED BY CS3353 AND SINCE ACCEPTED BY THE BUREAU OF LAND MANAGEMENT IN 2014.

THE BOUNDARIES WERE MARKED WITH 3/8" X 6' FIBERGLASS RODS AND RED AND WHITE FLAGGING. THE LINES WERE BLAZED AND PAINTED ORANGE.

ASSISTING IN THIS SURVEY WAS JOHN HOSHALL.

BASIS OF BEARING
NORTH 88'37'48" WEST BETWEEN THE EAST 1/16TH CORNER AND THE 1/4 CORNER COMMON TO SECTION
30 AND 31 AS SHOWN PER 2014 BLM DEPENDENT RESURVEY — SUBDIVISION OF SECTION 31

REFERENCE SURVEYS

1) BLM DEPENDENT RESURVEY SUBDIVISION OF SECTION 31, APPROVED NOVEMBER 7TH, 2014
2) CS 3353 BY JERRY C. OLSON, RECORDED JANUARY 1983

REGISTERED PROFESSIONAL LAND SURVEYOR

OREGON / Corey M. Woodruff 62978

EXPIRES 6/30/26

LEGEND FOUND MONUMENT PER CS 3353 BOUNDARY POSTED DURING THIS SURVEY RECORD SURVEY DIMENSION () APPROXIMATE LOCATION OF DOG CREEK



2318-B PACIFIC AVENUE FOREST GROVE, OR 97116

PHONE: (503) 357-5717 FAX: (503) 357-5698 www.stuntzner.com

JOB #: 324036 DATE: 10/28/2024 DRAWN BY: JMH

Engineering - Land Surveying - Forestry - Land Planning - Water Rights Weyerhaeuser Company 220 Occidental Ave. South Seattle, WA 98104 CHECKED BY: CMW FILE NAME: ROS-C.dwg SHEET 1 OF 1

CN 1/16TH CORNER SECTION 31 FOUND 1-1/2" IRON PIPE & BRASS CAP PER SN3353, 6" ABOVE GROUND