


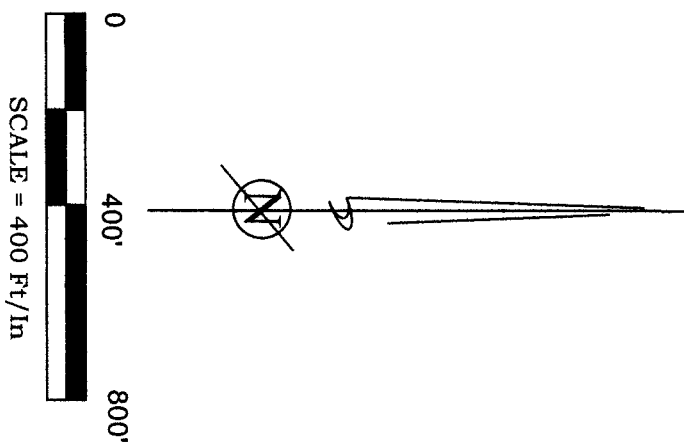

INSTRUMENT NO. 2022-08854

INSTRUMENT NO. 2018-008629

NARRATIVE:

--THIS SURVEY WAS ACCOMPLISHED AT THE REQUEST OF WEYERHAEUSER COMPANY TO MARK AND MONUMENT THE BOUNDARY LINES SHOWN AS HATCHED IN SECTIONS 23 & 26 TOWNSHIP 5 NORTH, RANGE 4 WEST OF THE WILLAMETTE MERIDIAN.

--THE BASIS OF BEARINGS IS OREGON COORDINATE REFERENCE SYSTEM PORTLAND ZONE, NAD83 (2011) EPOCH 2010.00.

--FOR CONTROL I HELD THE MONUMENTS AS NOTED IN THE MONUMENT NOTES.

--ALL REFERENCES WERE MEASURED WITH A HAND COMPASS SET AT DECLINATION 16° EAST AND A STEEL TAPE. ALL NEW BEARING TREES WERE MEASURED TO THE HEAD OF A 60D SPIKE SET IN THE BASE BLAZE BETWEEN THE 'B' AND THE 'T'. BEARING TREE TAGS WERE PLACED AT SHOULDER HEIGHT ABOVE THE BLAZES.

--BOUNDARY LINES SHOWN AS HATCHED WERE MARKED WITH RED AND WHITE RIBBON ON LINE. TREES ON WEYERHAEUSER PROPERTY WITHIN 10' OF THE BOUNDARY LINE WERE MARKED WITH QUARTER BLAZES AT CHEST HEIGHT FACING TOWARDS THE BOUNDARY LINE. TREES LOCATED DIRECTLY ON LINE WERE MARKED WITH TWO BLAZES AT CHEST HEIGHT AND, ON THE BOUNDARY LINE ON BOTH SIDES OF THE TREES, 3/8" X 6" WHITE FIBERGLASS POSTS WERE SET ON LINE AT 150' MAXIMUM INTERVALS.

HIGHWAY 47:

I HELD THE RESOLUTION OF THE CENTERLINE PER CS NO. 5858 ROTATED CLOCKWISE 00°17'23" TO FIT MY BASIS OF BEARINGS. THE PORTION EAST OF STATION 564+50 I HELD THE AS TRAVELLED CENTERLINE. SHOWN FOR GRAPHICAL PURPOSES ONLY.

SCAPOOSE VERNONIA HWY:

--I HELD THE RECORD DATA PER ODOT HWY MAP 8B-15-8 AND FIT IT TO THE AS TRAVELLED CENTERLINE AND AN 80' WIDTH. SHOWN FOR GRAPHICAL PURPOSES ONLY.

ELLIS TRACT, INSTRUMENT NO. 2018-008629:

I HELD MONUMENTS 416 & 464 FOR THE EAST LINE. I HELD MONUMENT 464 & THE CALCULATED POSITION 261 FOR THE NORTH LINE.

TITUS TRACT, INSTRUMENT NO. 2004-012503:


--FOR THE EAST LINE I HELD MONUMENTS 1139 AND 1140 PER CS NO 5179. I HELD THE RECORD ANGLE AT MONUMENT NO. 1140 AND REESTABLISHED THE SOUTHEAST CORNER AT THE RECORD DISTANCE PER CS NO. 5179. I HELD THE RECORD ANGLE AT THE SOUTHEAST CORNER AND SET A POINT ON LINE AT THE TOP OF THE BANK FOR THE NEHALEM RIVER.


GWINN & SONS LOGGING, INSTRUMENT NO. 2010-001148:

--FOR THE EAST LINE I HELD THE MONUMENTATION PER CS NO. 3626 AND THE DEED.

SHEET INDEX:

- 1.) OVERALL SURVEY & NARRATIVE
- 2.) DETAIL
- 3.) MONUMENT NOTES & REFERENCES

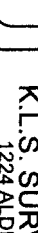REGISTERED PROFESSIONAL LAND SURVEYOR  OREGON JANUARY 19, 1993 DONALD D WALLACE, JR 2601 RENEWALS 6/30/26	 K S N E K.L.S. SURVEYING INC. 1224 ALDER STREET VERNONIA, OREGON 97064 (503) 429-6115	RECORD OF SURVEY FOR WEYERHAEUSER IN THE E 1/2 OF SECTION 26, & IN THE SW 1/4 OF SECTION 23, T5N, R4W, W.M., COLUMBIA COUNTY, OREGON NOVEMBER 11, 2025	SHEET 1 OF 3 DRAWN BY: ORM FIELD: SWMUR/BJT EQUIPMENT: NOMAD/NIXON JOB NO. 14-015 P DRAWING NAME: 25-094 ROS S1 REVISED: 12-23-2025
--	---	--	--

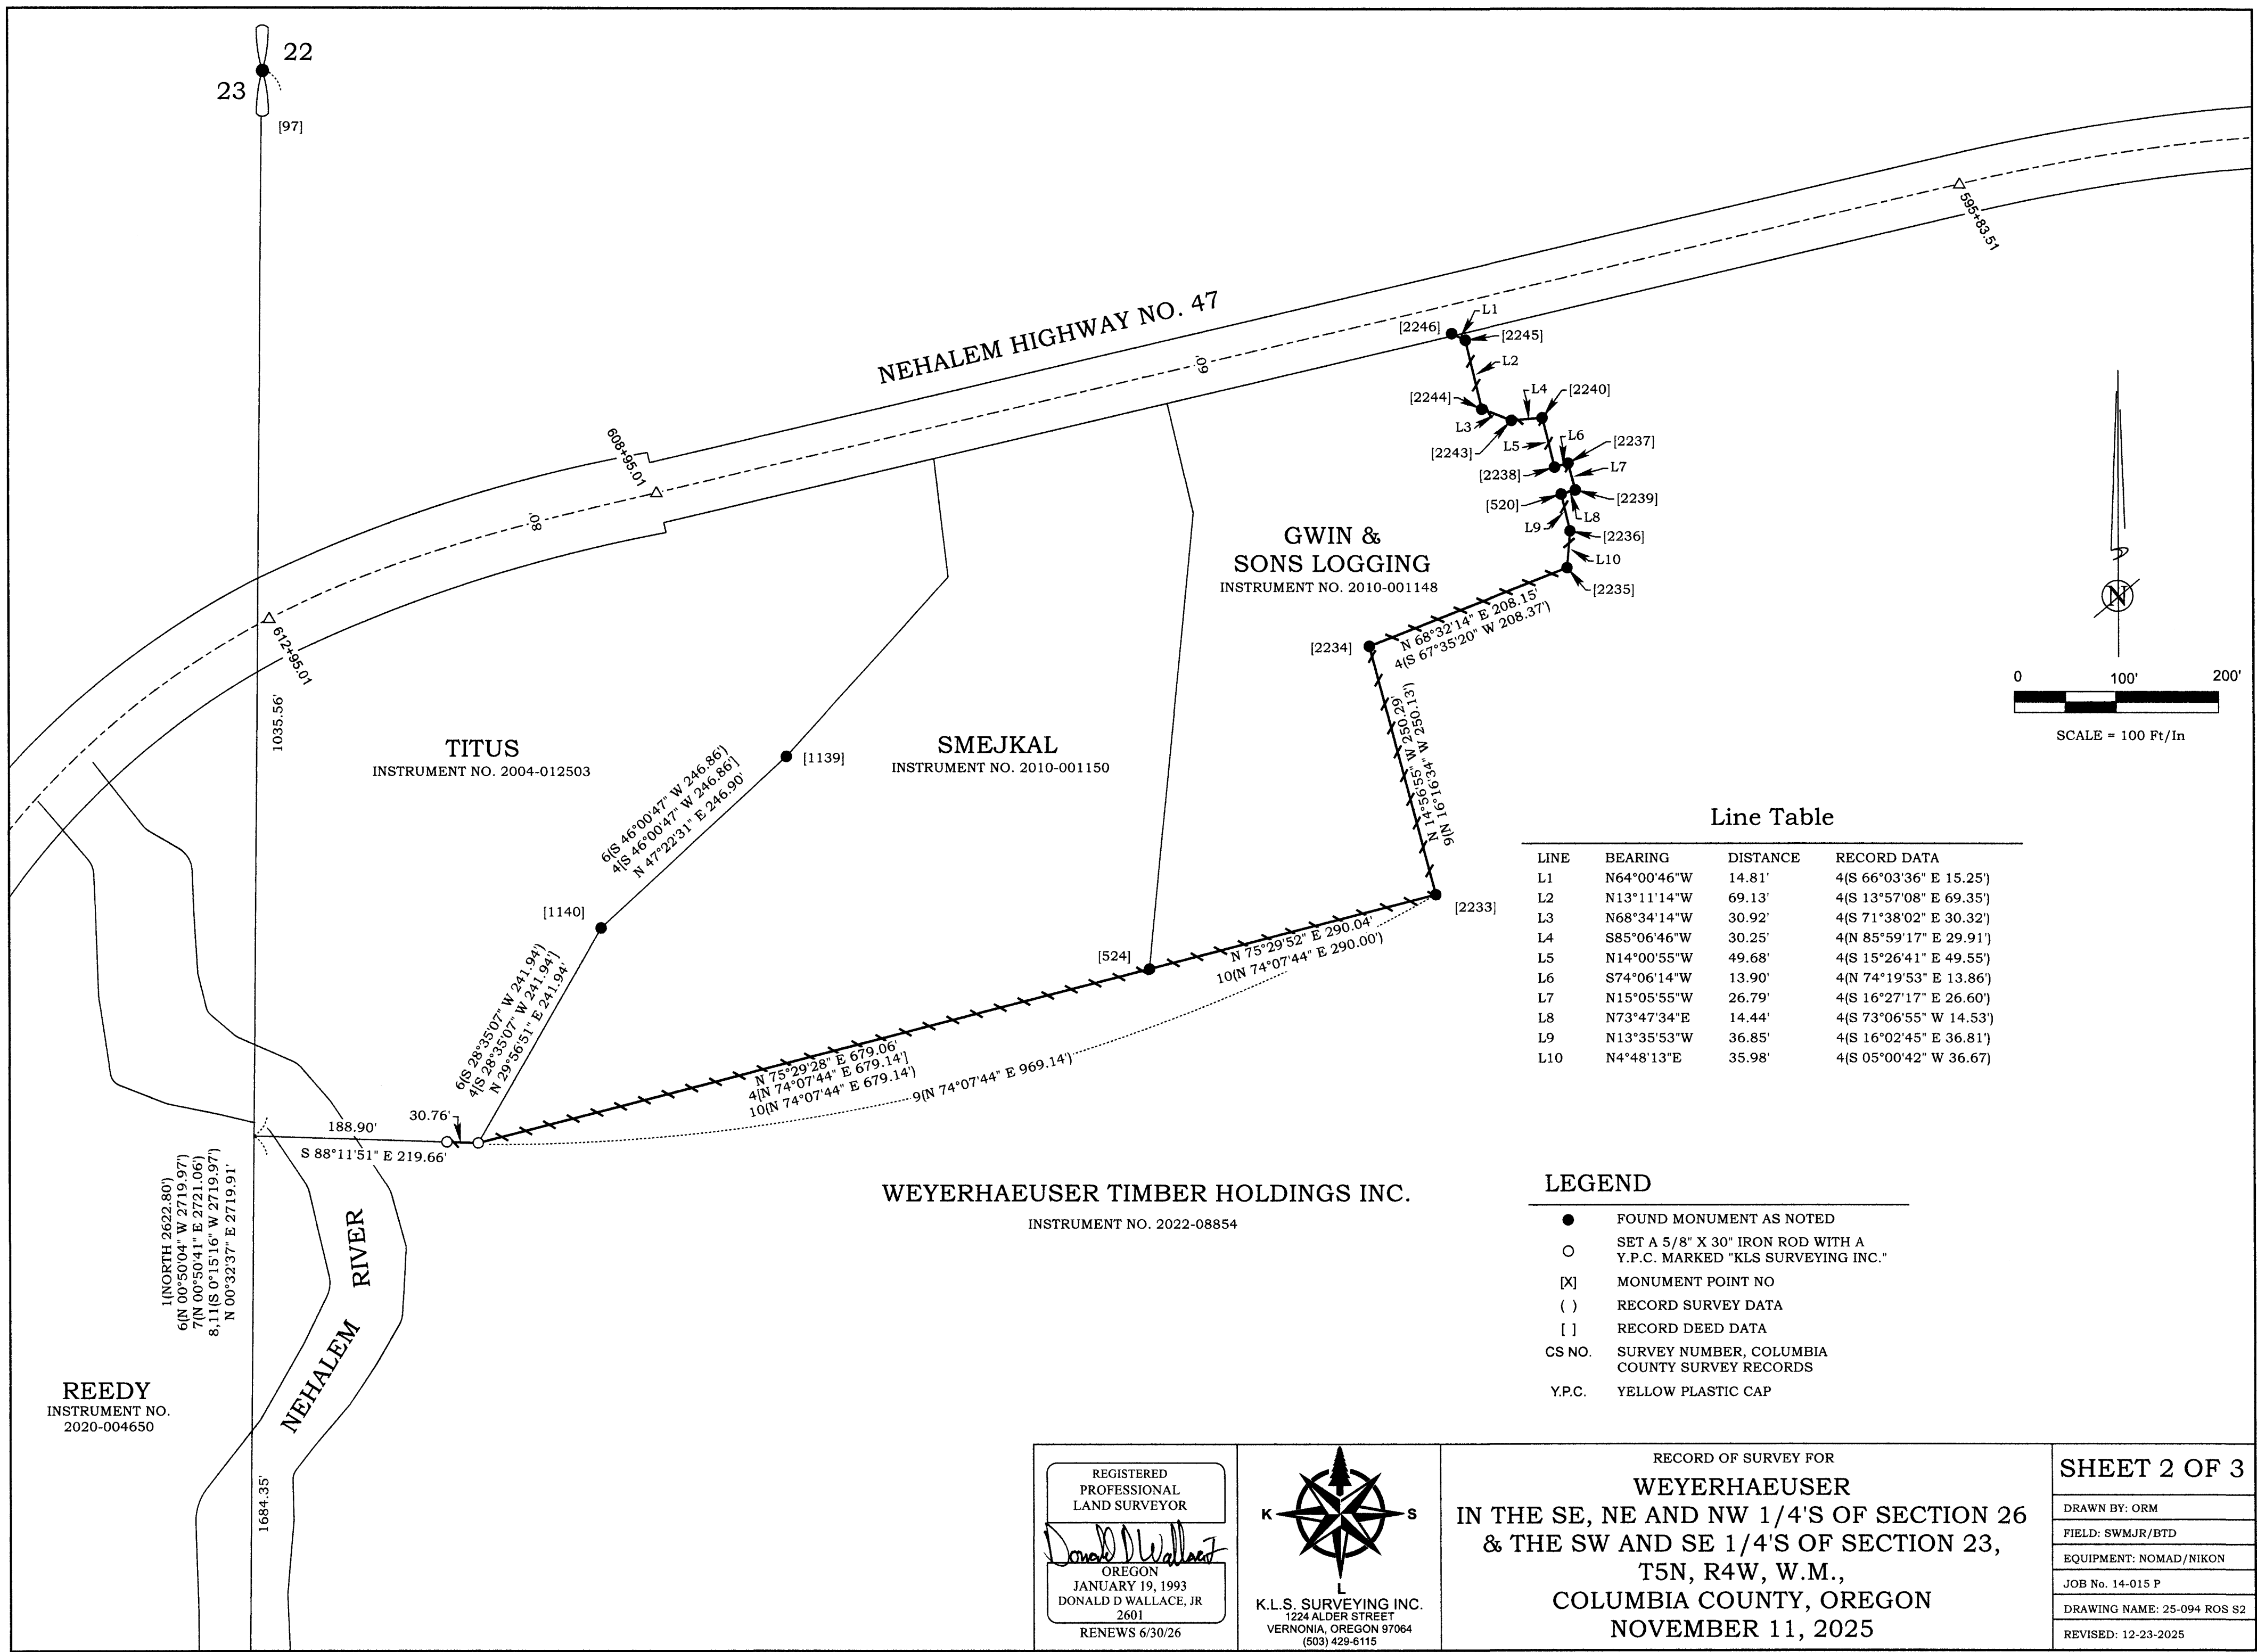

Line Table

LINE	BEARING	DISTANCE	RECORD DATA
L1	N64°00'46"W	14.81'	4(S 66°03'36" E 15.25')
L2	N13°11'14"W	69.13'	4(S 13°57'08" E 69.35')
L3	N68°34'14"W	30.92'	4(S 71°38'02" E 30.32')
L4	S85°06'46"W	30.25'	4(N 85°59'17" E 29.91')
L5	N14°00'55"W	49.68'	4(S 15°26'41" E 49.55')
L6	S74°06'14"W	13.90'	4(N 74°19'53" E 13.86')
L7	N15°05'55"W	26.79'	4(S 16°27'17" E 26.60')
L8	N73°47'34"E	14.44'	4(S 73°06'55" W 14.53')
L9	N13°35'53"W	36.85'	4(S 16°02'45" E 36.81')
L10	N4°48'13"E	35.98'	4(S 05°00'42" W 36.67')

LEGEND

- FOUND MONUMENT AS NOTED
- SET A 5/8" X 30" IRON ROD WITH A Y.P.C. MARKED "KLS SURVEYING INC."
- [X] MONUMENT POINT NO
- () RECORD SURVEY DATA
- [] RECORD DEED DATA
- CS NO. SURVEY NUMBER, COLUMBIA COUNTY SURVEY RECORDS
- Y.P.C. YELLOW PLASTIC CAP

REGISTERED
PROFESSIONAL
LAND SURVEYOR

Donald D. Wallace, Jr.

OREGON
JANUARY 19, 1993
DONALD D. WALLACE, JR
2601

RENEWS 6/30/26

K L S SURVEYING INC.
1224 ALDER STREET
VERNONIA, OREGON 97064
(503) 429-6115

RECORD OF SURVEY FOR

WEYERHAEUSER

IN THE SE, NE AND NW 1/4'S OF SECTION 26
& THE SW AND SE 1/4'S OF SECTION 23,
T5N, R4W, W.M.,
COLUMBIA COUNTY, OREGON
NOVEMBER 11, 2025

SHEET 2 OF 3

DRAWN BY: ORM
FIELD: SWMJR/BTD
EQUIPMENT: NOMAD/NIKON
JOB No. 14-015 P
DRAWING NAME: 25-094 ROS S2
REVISED: 12-23-2025

MONUMENT NOTES:

[89]
FOUND A 5/8" IRON ROD WITH A Y.P.C. MARKED "KLS SURVEYING INC" PER CS NO 5209, (HELD)

[97]
1/4 CORNER COMMON TO SECTIONS 22 & 23
FOUND A 1" IRON PIPE PER CS NO. 3626, (HELD)
A 1" IRON PIPE BEARS N 8°26'02" E 0.91', UP 6"

[261]
SECTION CORNER COMMON TO SECTIONS 22, 23, 26, & 27
CALCULATED POSITION OF THE 3/4" IRON BAR NOTED ON CS NO. 4585
CORNER FALLS IN NEHALEM RIVER

[416]
FOUND A 3" BRASS CAP PER CS NO. 3509, (HELD)
REFERENCES FOUND:
A 36" FIR BEARS N 26° E 2.70' TO HEALED FACE
A 29" FIR BEARS N 76° W 11.15' TO HEALED FACE

[464]
1/4 CORNER COMMON TO SECTIONS 23 & 26
FOUND A 3" BRASS CAP PER CS NO. 3509, (HELD)
REFERENCES FOUND:
18" ROTTEN FIR STUMP BEARS S 85° W 51.65' TO VISIBLE FACE
NEW REFERENCES:
A FIBERGLASS POST BEARS NORTH 0.30'
AN 11" FIR SCRIBED "1/4 S26 BT" BEARS S 03° W 23.47' TO SPIKE
A 17" CEDAR SCRIBED "1/4 S26 BT" BEARS S 70° E 38.69' TO SPIKE
A 16" FIR SCRIBED "1/4 S23 BT" BEARS N 10° W 32.63' TO SPIKE
A 7" FIR SCRIBED "X BT" BEARS N 86°W 51.25' TO SPIKE

[520]
FOUND A 5/8" IRON ROD WITH A Y.P.C. MARKED "L. JERRY KEENON PLS 1080" PER CS NO. 3626, (HELD)

[524]
FOUND A BENT 5/8" IRON ROD, STRAIGHTENED & RESET, PER CS NO. 5731, (HELD)
A 1/2" FIBERGLASS POST BEARS EAST 0.50'

[1139]
FOUND A 5/8" IRON ROD WITH A Y.P.C. MARKED "KEENON LAND SERVICES INC" PER CS NO. 5179, (HELD)

[1140]
FOUND A 5/8" IRON ROD WITH AN ILLEGIBLE Y.P.C. PER CS NO. 5179, (HELD)

MONUMENT NOTES CONTINUED:

[2233]
FOUND A 5/8" IRON ROD WITH A Y.P.C. MARKED "KLS SURVEYING INC" PER CS NO. 5610, (HELD)
A 5/8" X 6' FIBERGLASS POST BEARS SOUTH 0.20'

[2234]
FOUND A 3" X 5 1/2' TALL GALVANIZED FENCE POST AS NOTED ON CS NO. 3626, (HELD)

[2235]
FOUND A 3" X 6' TALL GALVANIZED FENCE POST AS NOTED ON CS NO. 3626, (HELD)

[2236]
FOUND A 3" X 6' TALL GALVANIZED FENCE POST AS NOTED ON CS NO. 3626, (HELD)

[2237]
FOUND A 5/8" IRON ROD WITH A Y.P.C. MARKED "L. JERRY KEENON PLS 1080" PER CS NO. 3626, (HELD)

[2238]
FOUND A 5/8" IRON ROD WITH A Y.P.C. MARKED "L. JERRY KEENON PLS 1080" PER CS NO. 3626, (HELD)

[2239]
FOUND A 5/8" IRON ROD WITH A Y.P.C. MARKED "L. JERRY KEENON PLS 1080" PER CS NO. 3626, (HELD)

[2240]
FOUND A 3" X 7 1/2' TALL GALVANIZED FENCE POST AS NOTED ON CS NO. 3626, (HELD)

[2243]
FOUND A 6" X 7' TALL GALVANIZED FENCE POST AS NOTED ON CS NO. 3626, (HELD)

[2244]
FOUND A 6" X 7' TALL GALVANIZED FENCE POST AS NOTED ON CS NO. 3626, (HELD)


[2245]
FOUND A 2" GALVANIZED I-BEAM FENCE POST, BENT, AS NOTED ON CS NO. 3626, (HELD)

[2246]
FOUND A 3" GALVANIZED FENCE POST AS NOTED ON CS NO. 3626
MONUMENT BEARS N 13°17'12" W 2.47' FROM THE SOUTHERLY RIGHT OF WAY LINE OF HIGHWAY NO. 47

REFERENCES:

SURVEYS
1 = CS NO. 1821
2 = CS NO. 3280
3 = CS NO. 3509
4 = CS NO. 3626
5 = CS NO. 4272
6 = CS NO. 5179
7 = CS NO. 5209
8 = CS NO. 5858
9 = CS NO. 5610
10 = CS NO. 5731
11 = CS NO. 5888

DEEDS
1 = INSTRUMENT NO. 2004-09619
2 = INSTRUMENT NO. 2004-012503
3 = INSTRUMENT NO. 2010-001148
4 = INSTRUMENT NO. 2010-001150
5 = INSTRUMENT NO. 2018-008629
6 = INSTRUMENT NO. 2020-004650
7 = INSTRUMENT NO. 2022-08854
8 = INSTRUMENT NO. 2025-000958

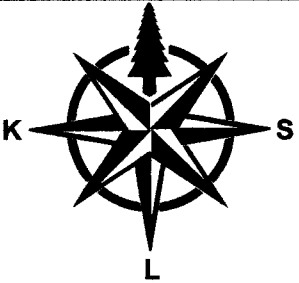REGISTERED PROFESSIONAL LAND SURVEYOR  OREGON JANUARY 19, 1993 DONALD D WALLACE, JR 2601 RENEWS 6/30/26	 K S L V K.L.S. SURVEYING INC. 1224 ALDER STREET VERNONIA, OREGON 97064 (503) 429-6115	RECORD OF SURVEY FOR WEYERHAEUSER IN THE E 1/2 OF SECTION 26, & IN THE SW 1/4 OF SECTION 23, T5N, R4W, W.M., COLUMBIA COUNTY, OREGON NOVEMBER 11, 2025	SHEET 3 OF 3
			DRAWN BY: ORM
			FIELD: SWMJR/BTD
			EQUIPMENT: NOMAD/NIKON
			JOB No. 14-015 P
			DRAWING NAME: 25-094 ROS S3
REVISED: 12-23-2025			