


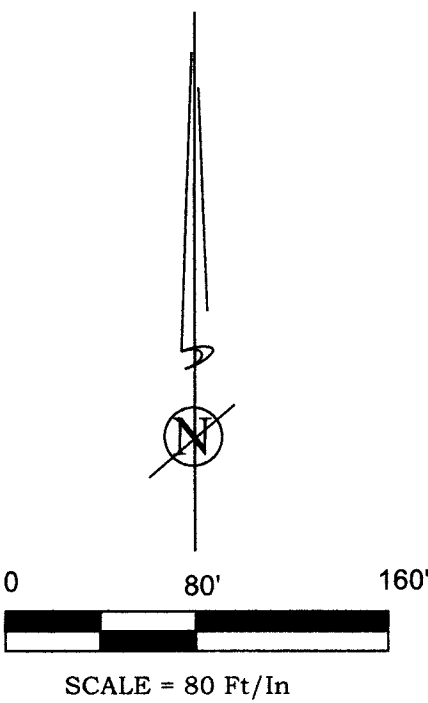

NARRATIVE:

--THIS SURVEY WAS ACCOMPLISHED AT THE REQUEST OF DAVID THORPE TO MARK AND MONUMENT THAT TRACT OF LAND CONVEYED TO DAVID THORPE IN CLERKS INSTRUMENT NO. 2018-006371, COLUMBIA COUNTY DEED RECORDS.

--THE BASIS OF BEARINGS IS OREGON COORDINATE REFERENCE SYSTEM PORTLAND ZONE, NAD83 (2011) EPOCH 2010.00.

--FOR CONTROL I HELD THE MONUMENTS AS NOTED.

THORPE TRACT:


--THIS TRACT WAS ORIGINALLY SURVEYED IN 1968 BY PHIL DEWEY, SHOWN AS ADDED TO CS NO. 1025. I HELD MONUMENTS 78, 89, & 98 FOR THE EAST LINE. I HELD THE DEEDED ANGLE [87°14'] AT THE NE CORNER AND ESTABLISHED A POINT ONLINE AT THE TOP OF THE RIGHT BANK OF THE NEHALEM RIVER. I HELD MONUMENT NO. 79 FOR A POINT ON THE SOUTH LINE.

--BOUNDARY LINES SHOWN AS HATCHED WERE MARKED WITH WOOD STAKES AND RED & WHITE FLAGGING ONLINE.

REFERENCES:

SURVEYS
1 = CS NO. 1025

DEEDS
1 = INSTRUMENT NO. 2018-006371
2 = INSTRUMENT NO. 2019-007742
3 = INSTRUMENT NO. 2022-03674

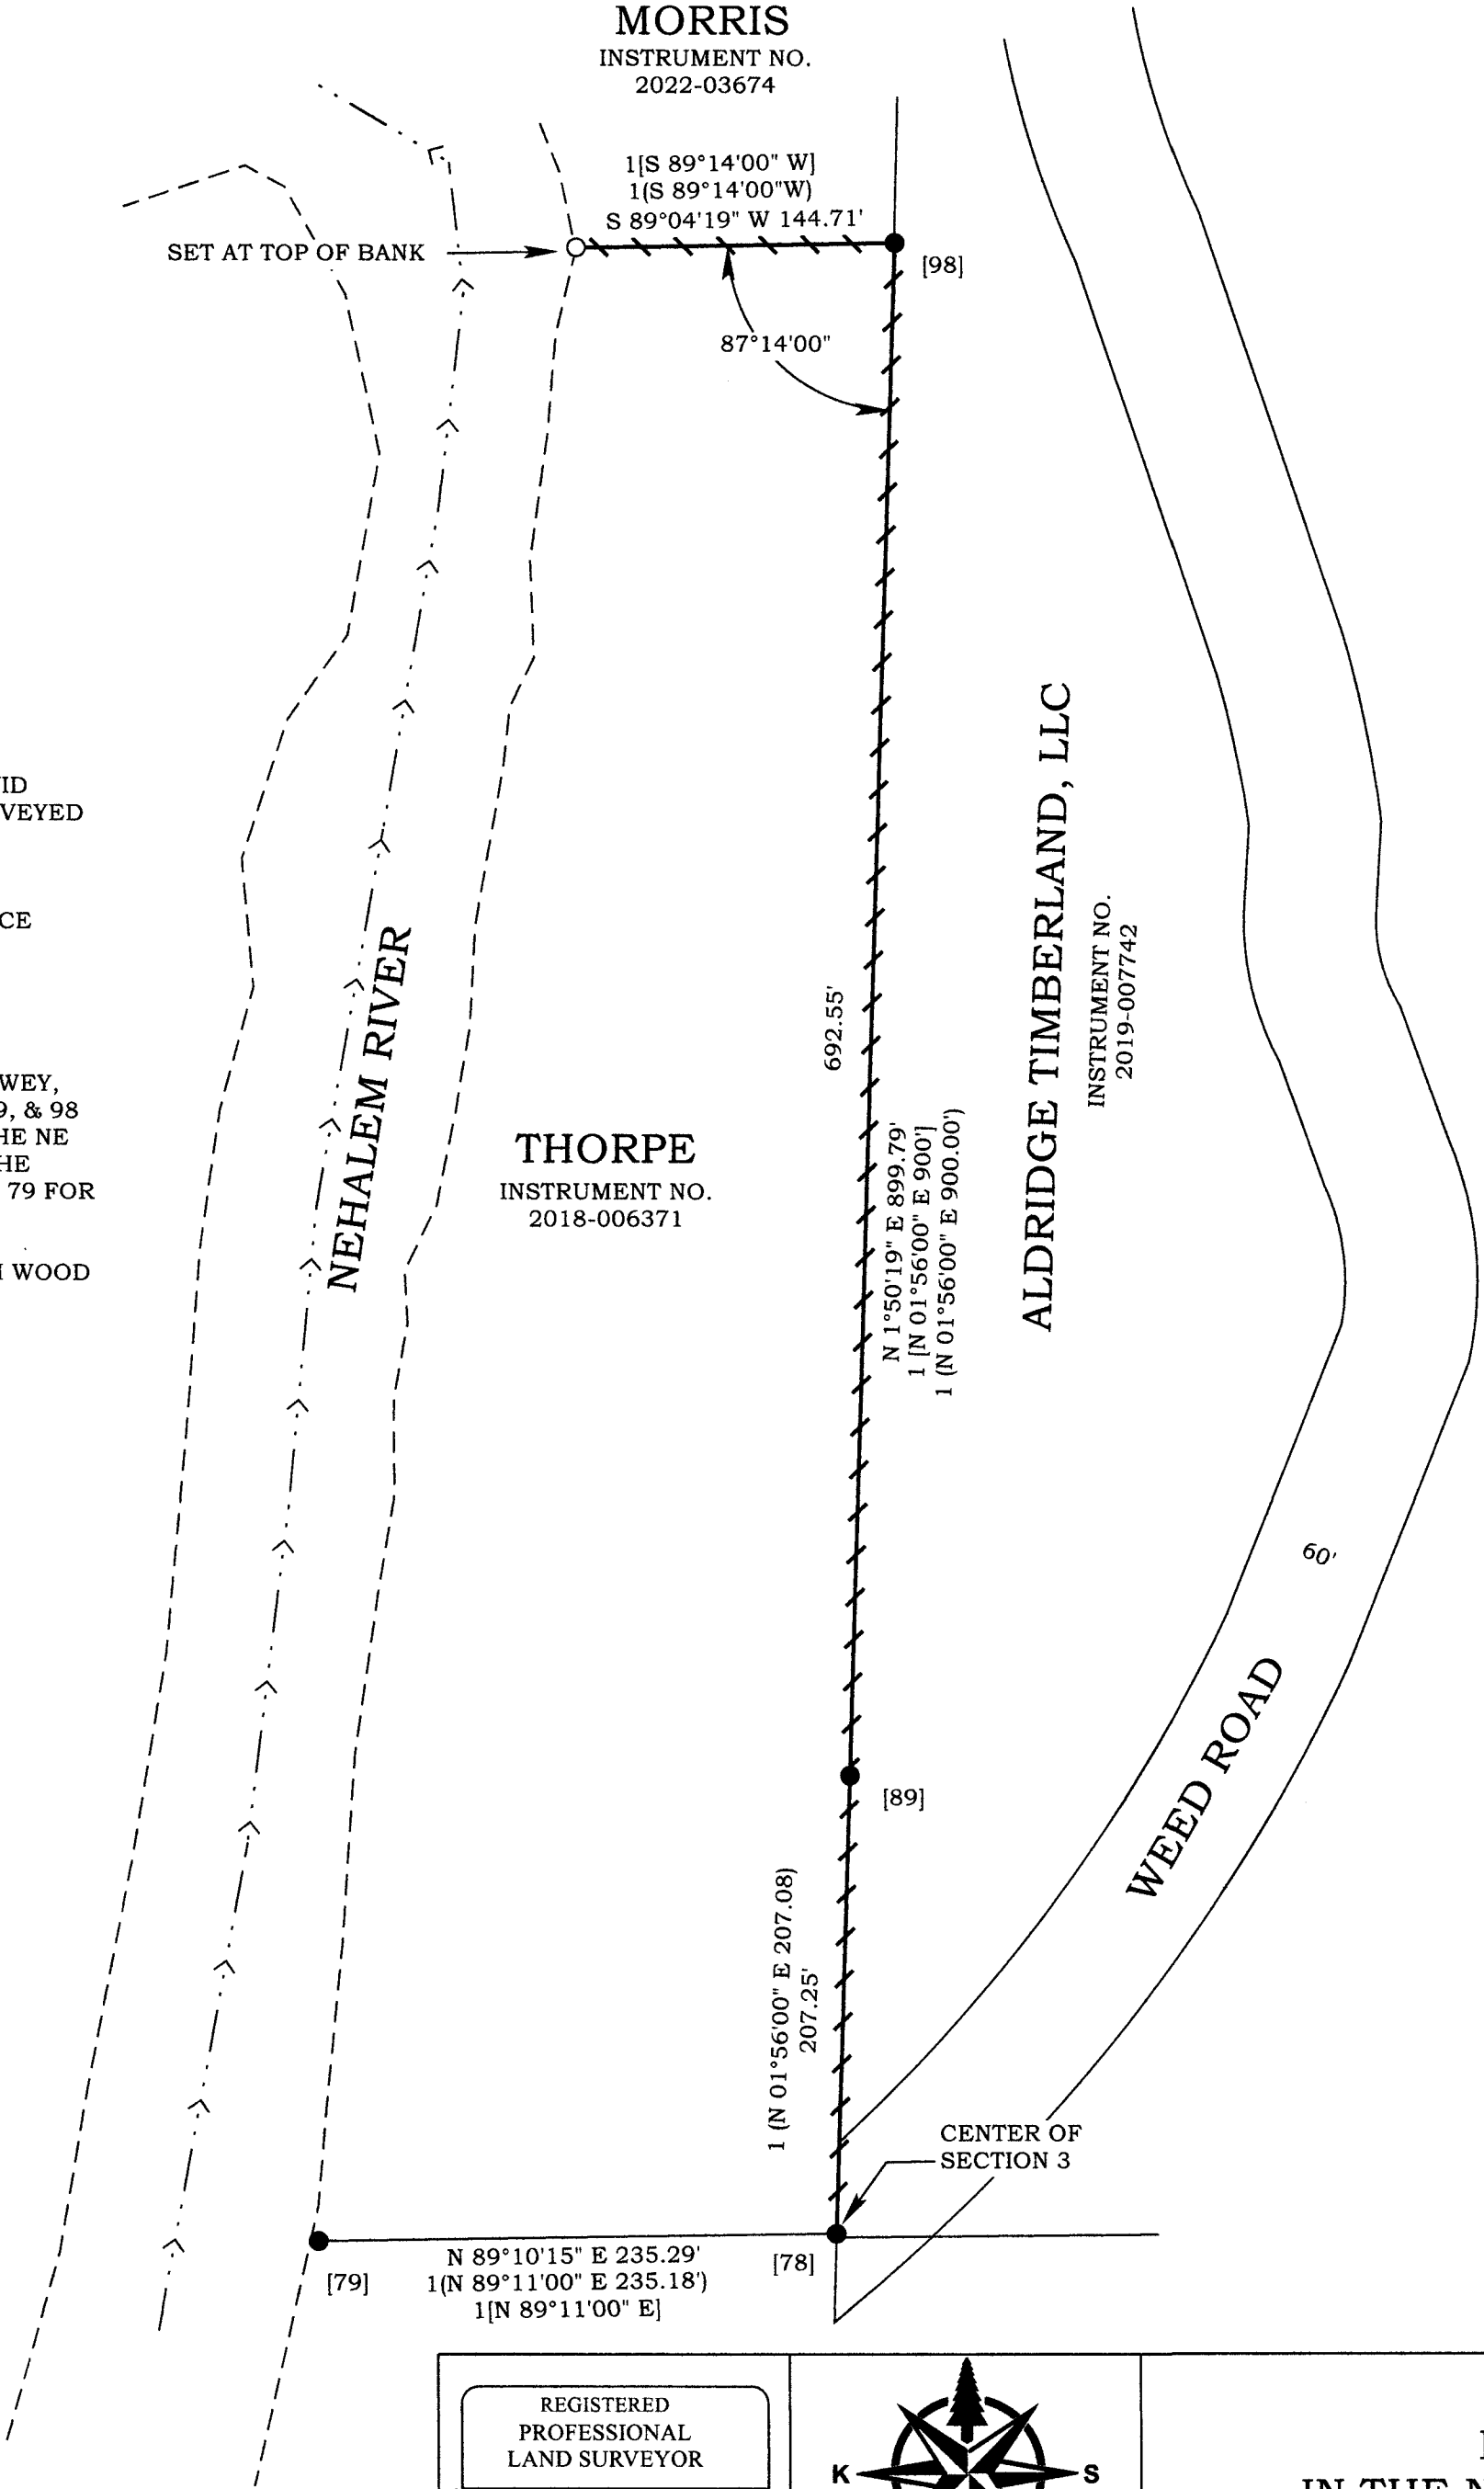

MONUMENT NOTES:

- [78]
CENTER OF SECTION 13
FOUND 1 1/2" IRON PIPE PER CS NO. 1025, (HELD)
- [79]
FOUND 5/8" IRON ROD PER CS NO. 1025, (HELD)
- [89]
FOUND 5/8" IRON ROD PER CS NO. 1025, (HELD)
- [98]
FOUND 5/8" IRON ROD PER CS NO. 1025, (HELD)

LEGEND

- FOUND MONUMENT AS NOTED
- SET A 5/8" X 30" IRON ROD WITH A Y.P.C. MARKED "KLS SURVEYING INC."
- [X] MONUMENT POINT NO
- () RECORD SURVEY DATA
- [] RECORD DEED DATA
- CS NO. SURVEY NUMBER, COLUMBIA COUNTY SURVEY RECORDS
- Y.P.C. YELLOW PLASTIC CAP

REGISTERED
PROFESSIONAL
LAND SURVEYOR

Donald D. Wallace
OREGON
JANUARY 19, 1993
DONALD D. WALLACE, JR
2601
RENEWES 6/30/26

K
S
L
K.L.S. SURVEYING INC.
1224 ALDER STREET
VERNONIA, OREGON 97064
(503) 429-6115

RECORD OF SURVEY FOR

DAVID THORPE
IN THE NW 1/4 OF SECTION 13,
T4N, R5W, W.M.,
COLUMBIA COUNTY, OREGON
OCTOBER 28, 2025

DRAWN BY: BTD
FIELD: BTD/DDR
EQUIPMENT: NOMAD/NIKON
JOB No. 14-187
DRAWING NAME: 25-298 ROS
REVISED: 10/28/2025