
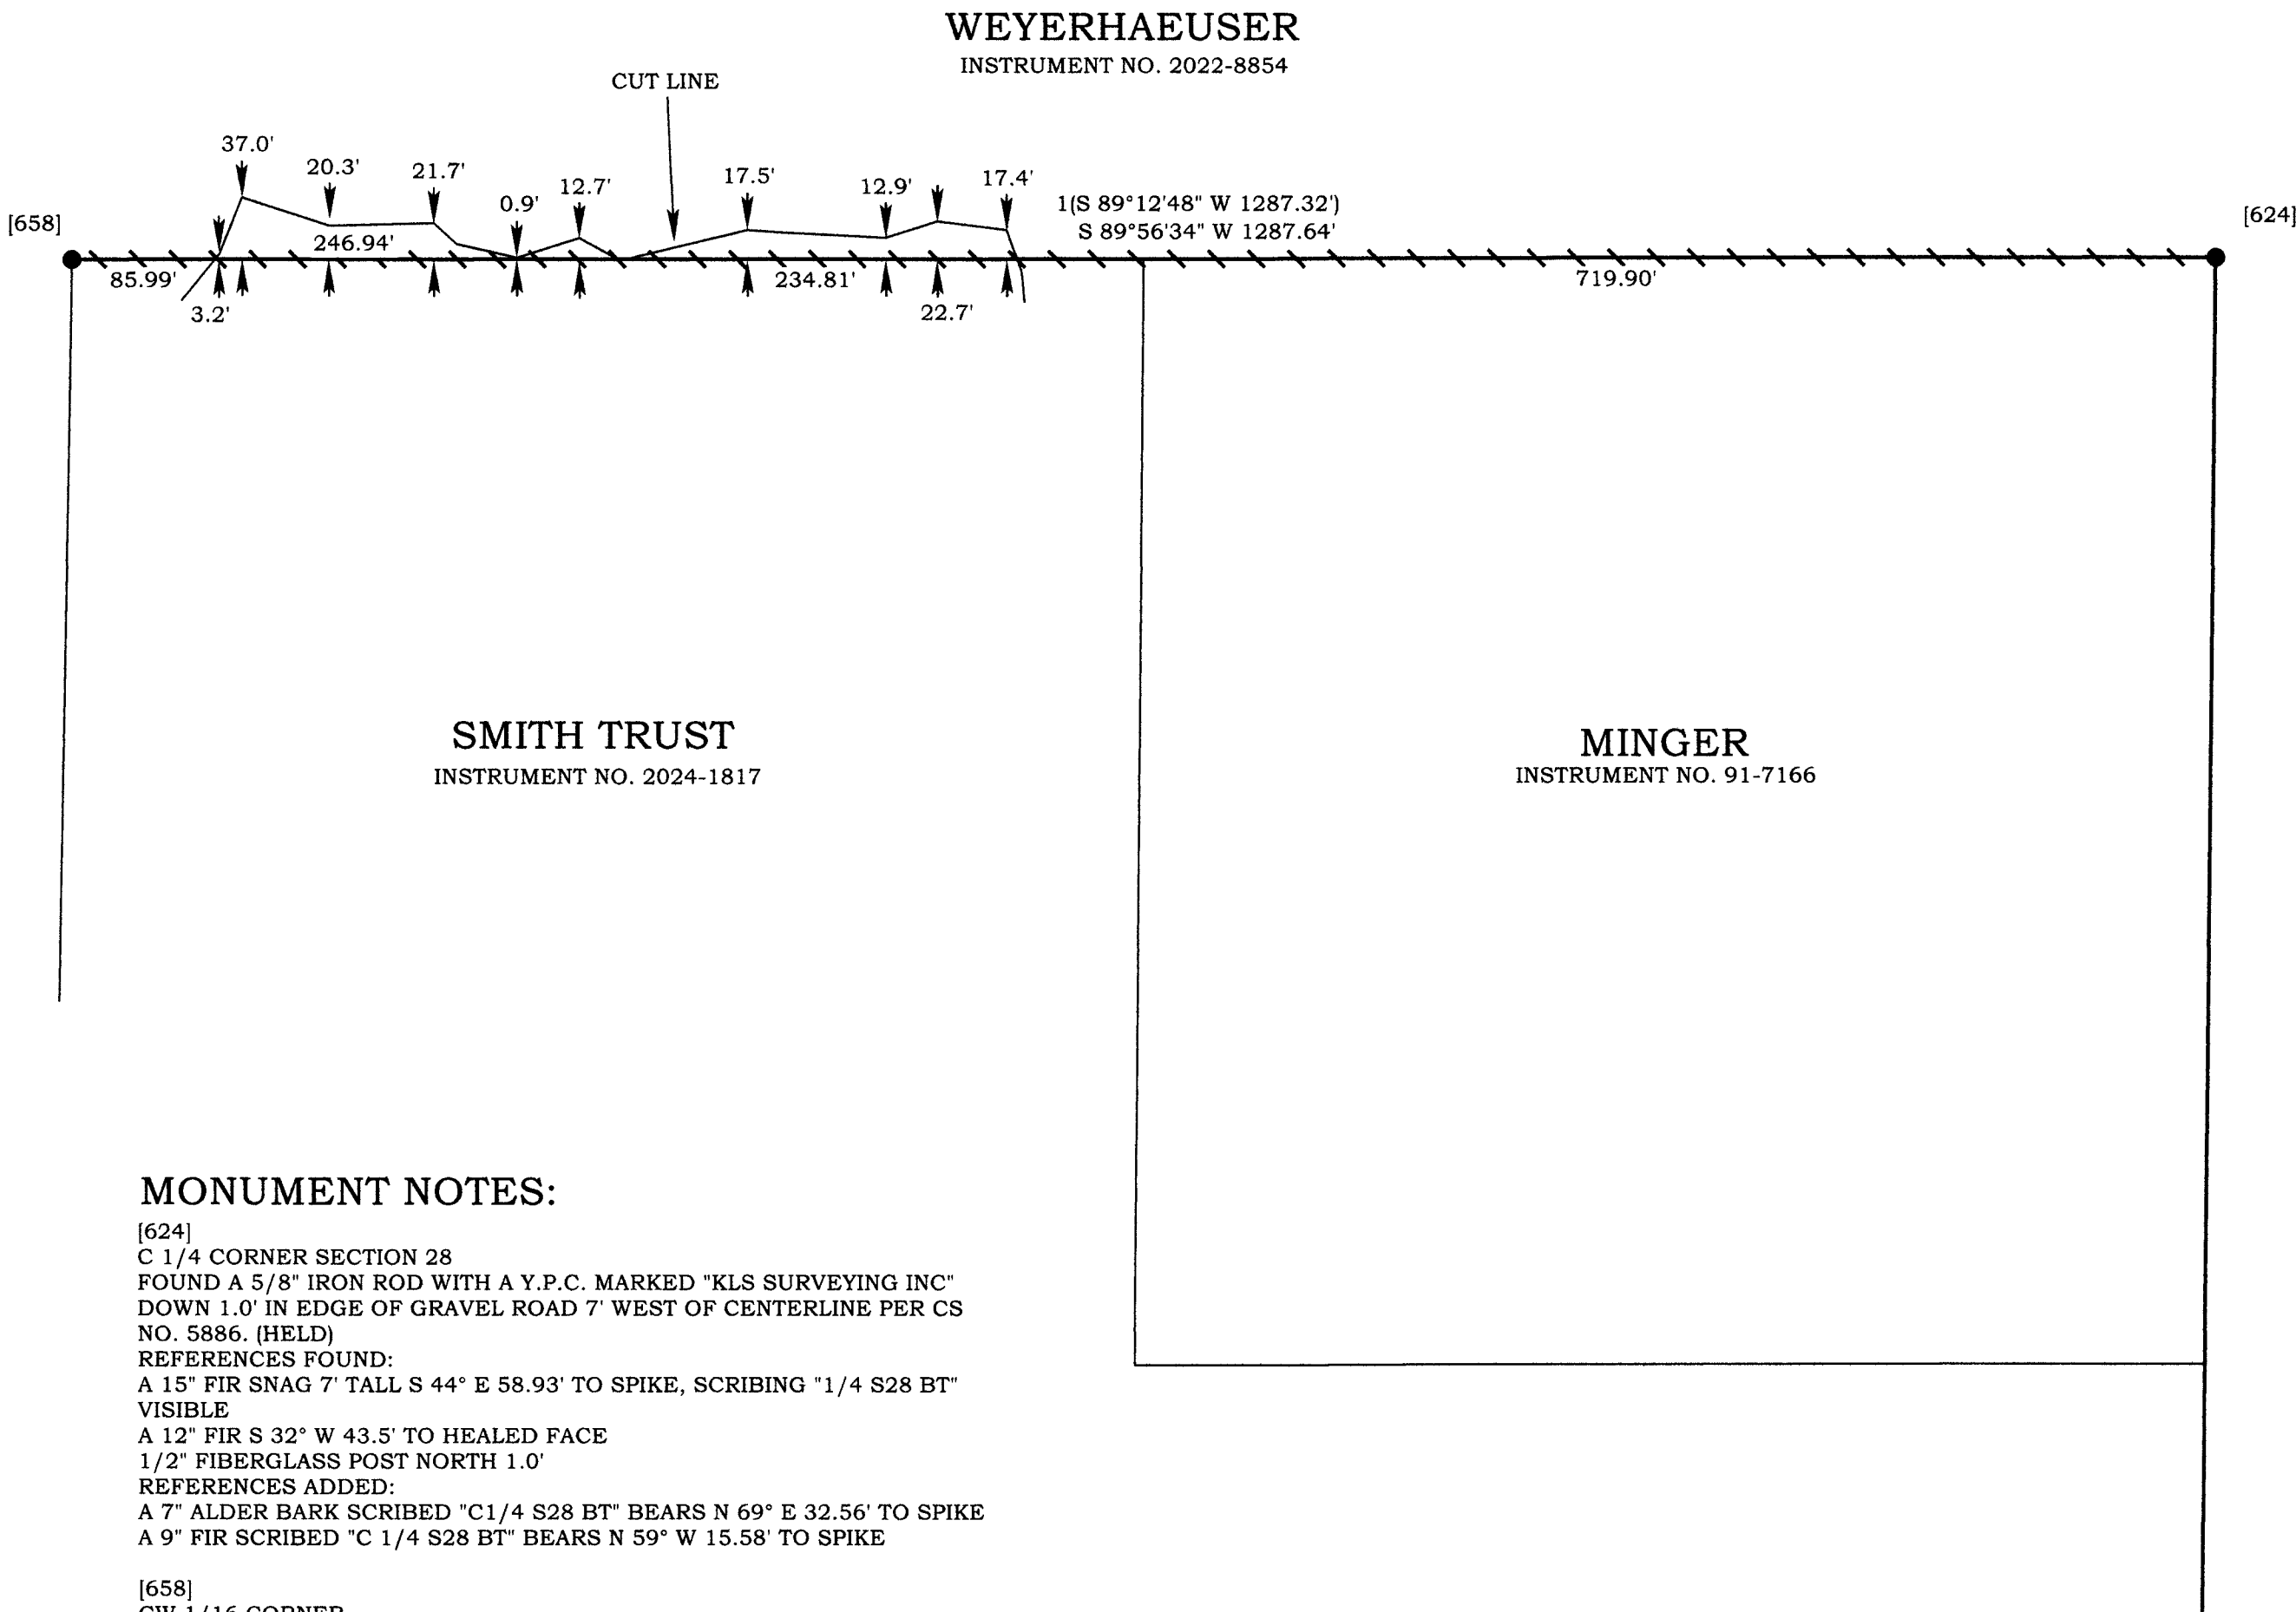


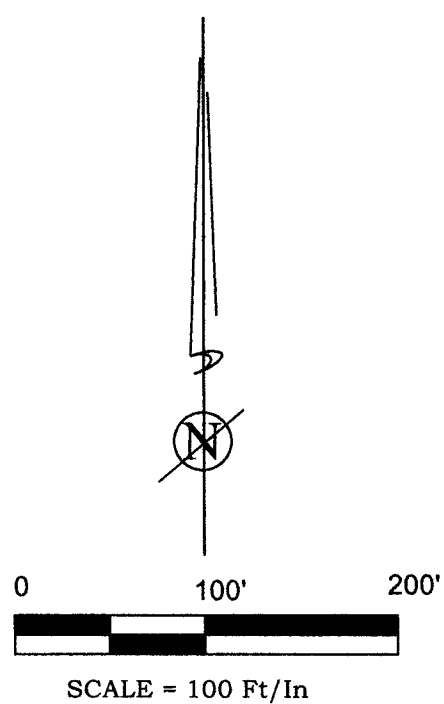

NARRATIVE:

--THIS SURVEY WAS ACCOMPLISHED AT THE REQUEST OF WEYERHAEUSER COMPANY TO MARK THE BOUNDARY LINES SHOWN AS HATCHED IN SECTION 28, TOWNSHIP 5 NORTH, RANGE 4 WEST OF THE WILLAMETTE MERIDIAN.

--THE BASIS OF BEARINGS IS OREGON COORDINATE REFERENCE SYSTEM PORTLAND ZONE, NAD83 (2011) EPOCH 2010.00.

--FOR CONTROL I HELD THE MONUMENTS AS NOTED IN THE MONUMENT NOTES.

--ALL REFERENCES WERE MEASURED WITH A HAND COMPASS SET AT DECLINATION 16° EAST AND A STEEL TAPE. ALL NEW BEARING TREES WERE MEASURED TO THE HEAD OF A 60D SPIKE SET IN THE BASE BLAZE BETWEEN THE "B" AND THE "T". BEARING TREE TAGS WERE PLACED AT SHOULDER HEIGHT ABOVE THE BLAZES.

--BOUNDARY LINES SHOWN AS HATCHED WERE MARKED WITH RED AND WHITE RIBBON ON LINE. TREES ON WEYERHAEUSER PROPERTY WITHIN 10' OF THE BOUNDARY LINE WERE MARKED WITH QUARTER BLAZES AT CHEST HEIGHT FACING TOWARDS THE BOUNDARY LINE. TREES LOCATED DIRECTLY ON LINE WERE MARKED WITH TWO BLAZES AT CHEST HEIGHT AND, ON THE BOUNDARY LINE ON BOTH SIDES OF THE TREES. 3/8" X 6' WHITE FIBERGLASS POSTS WERE SET ON LINE AT 150' MAXIMUM INTERVALS.

MONUMENT NOTES:

[624]
C 1/4 CORNER SECTION 28
FOUND A 5/8" IRON ROD WITH A Y.P.C. MARKED "KLS SURVEYING INC"
DOWN 1.0' IN EDGE OF GRAVEL ROAD 7' WEST OF CENTERLINE PER CS
NO. 5886. (HELD)
REFERENCES FOUND:
A 15" FIR SNAG 7' TALL S 44° E 58.93' TO SPIKE, SCRIBING "1/4 S28 BT"
VISIBLE
A 12" FIR S 32° W 43.5' TO HEALED FACE
1/2" FIBERGLASS POST NORTH 1.0'
REFERENCES ADDED:
A 7" ALDER BARK SCRIBED "C1/4 S28 BT" BEARS N 69° E 32.56' TO SPIKE
A 9" FIR SCRIBED "C 1/4 S28 BT" BEARS N 59° W 15.58' TO SPIKE

[658]
CW 1/16 CORNER
FOUND A 5/8" IRON ROD WITH A Y.P.C. MARKED "MORRIS PLS 401" PER CS
NO.3534. (HELD)
REFERENCES FOUND:
A ROTTEN HEMLOCK SNAG BEARS S 61° W 6.1' TO FACE, SCRIBING
VISIBLE
A WHITE FIBERGLASS POST SOUTH 0.1'
REFERENCE ADDED:
A 9" HEMLOCK SCRIBED "CW 1/16 S28 BT" BEARS S 8° E 5.83' TO SPIKE

LEGEND

- FOUND MONUMENT AS NOTED
- [X] MONUMENT POINT NO
- () RECORD SURVEY DATA
- CS SURVEY NUMBER, COLUMBIA COUNTY SURVEY RECORDS
- Y.P.C. YELLOW PLASTIC CAP

REFERENCES:

SURVEYS
1 = CS NO. 3534
2 = CS NO. 5886
3 = CS NO. M-530

DEEDS
1 = INSTRUMENT NO. 91-7166
2 = INSTRUMENT NO. 2022-8854
3 = INSTRUMENT NO. 2024-1817

REGISTERED
PROFESSIONAL
LAND SURVEYOR

OREGON
JANUARY 19, 1993
DONALD D WALLACE, JR
2601
RENEWS 6/30/26

K L S SURVEYING INC.
1224 ALDER STREET
VERNONIA, OREGON 97064
(503) 429-6115

RECORD OF SURVEY FOR
WEYERHAEUSER
IN THE NW 1/4 OF SECTION 28,
T5N, R4W, W.M.,
COLUMBIA COUNTY OREGON
DECEMBER 31, 2025

DRAWN BY: ORM
FIELD: SWMJR/BTD
EQUIPMENT: NOMAD/NIKON
JOB No. 12-016A
DRAWING NAME: 26-001
REVISED: 2-17-2026