

NARRATIVE:

--THIS SURVEY WAS COMPLETED AT THE REQUEST OF DAVID SIDERAS TO MONUMENT A PROPOSED PROPERTY LINE ADJUSTMENT BETWEEN LOTS 4-6, BLOCK 3, MALMSTEEN'S RIVERSIDE VIEW, CONTAINED IN CLERKS INSTRUMENT NO. 2025-005606, COLUMBIA COUNTY DEED RECORDS. THE NEW LINE WAS ESTABLISHED AT THE LOCATION SHOWN PER THE REQUEST OF OUR CLIENT.

--THE BASIS OF BEARINGS IS OREGON COORDINATE REFERENCE SYSTEM PORTLAND ZONE, NAD83 (2011) EPOCH 2010.00.

SUBJECT TRACT, INSTRUMENT NO. 2025-005606;

--FOR CONTROL I HELD THE BOUNDARY RESOLUTION AND MONUMENTATION PER CS NO. 6616, EXCEPT AS NOTED IN THE MONUMENT NOTES.

HIGHWAY 47:

-- I HELD THE RESOLUTION OF THE CENTERLINE OF HIGHWAY 47 PER CS NO. 5024 ROTATED COUNTERCLOCKWISE 01°35'19" BETWEEN COLUMBIA 02 AND ODOT CONTROL POINT 1021 (MONUMENT NO. 714). THE RECORD BEARING AND DISTANCE BETWEEN MONUMENTS IS N 81° 14'37" W 1969.21' AND MY MEASURED BEARING AND DISTANCE IS N 82° 49'56" W 1969.19'.

LEGEND

- FOUND A 5/8" IRON ROD WITH A Y.P.C. MARKED "S.W.L.S. INC 503-665-7777" PER CS NO. 6616, (HELD), UNLESS OTHERWISE NOTED
- SET A 5/8" X 30" IRON ROD WITH A Y.P.C. MARKED "KLS SURVEYING INC."
- [X] MONUMENT POINT NO
- () RECORD SURVEY DATA
- [] RECORD DEED DATA
- CS NO. SURVEY NUMBER, COLUMBIA COUNTY SURVEY RECORDS
- Y.P.C. YELLOW PLASTIC CAP
- S.F. SQUARE FEET


REFERENCES:

SURVEYS
1 = CS NO. 6616
2 = MALMSTENS RIVERSIDE VIEW

DEEDS
1 = INSTRUMENT NO. 2015-002549
2 = INSTRUMENT NO. 2021-09584
3 = INSTRUMENT NO. 2022-05724
4 = INSTRUMENT NO. 2024-06611
5 = INSTRUMENT NO. 2025-005606

NOTE:



CITY OF VERNONIA PLANNING FILE LLA 26-01

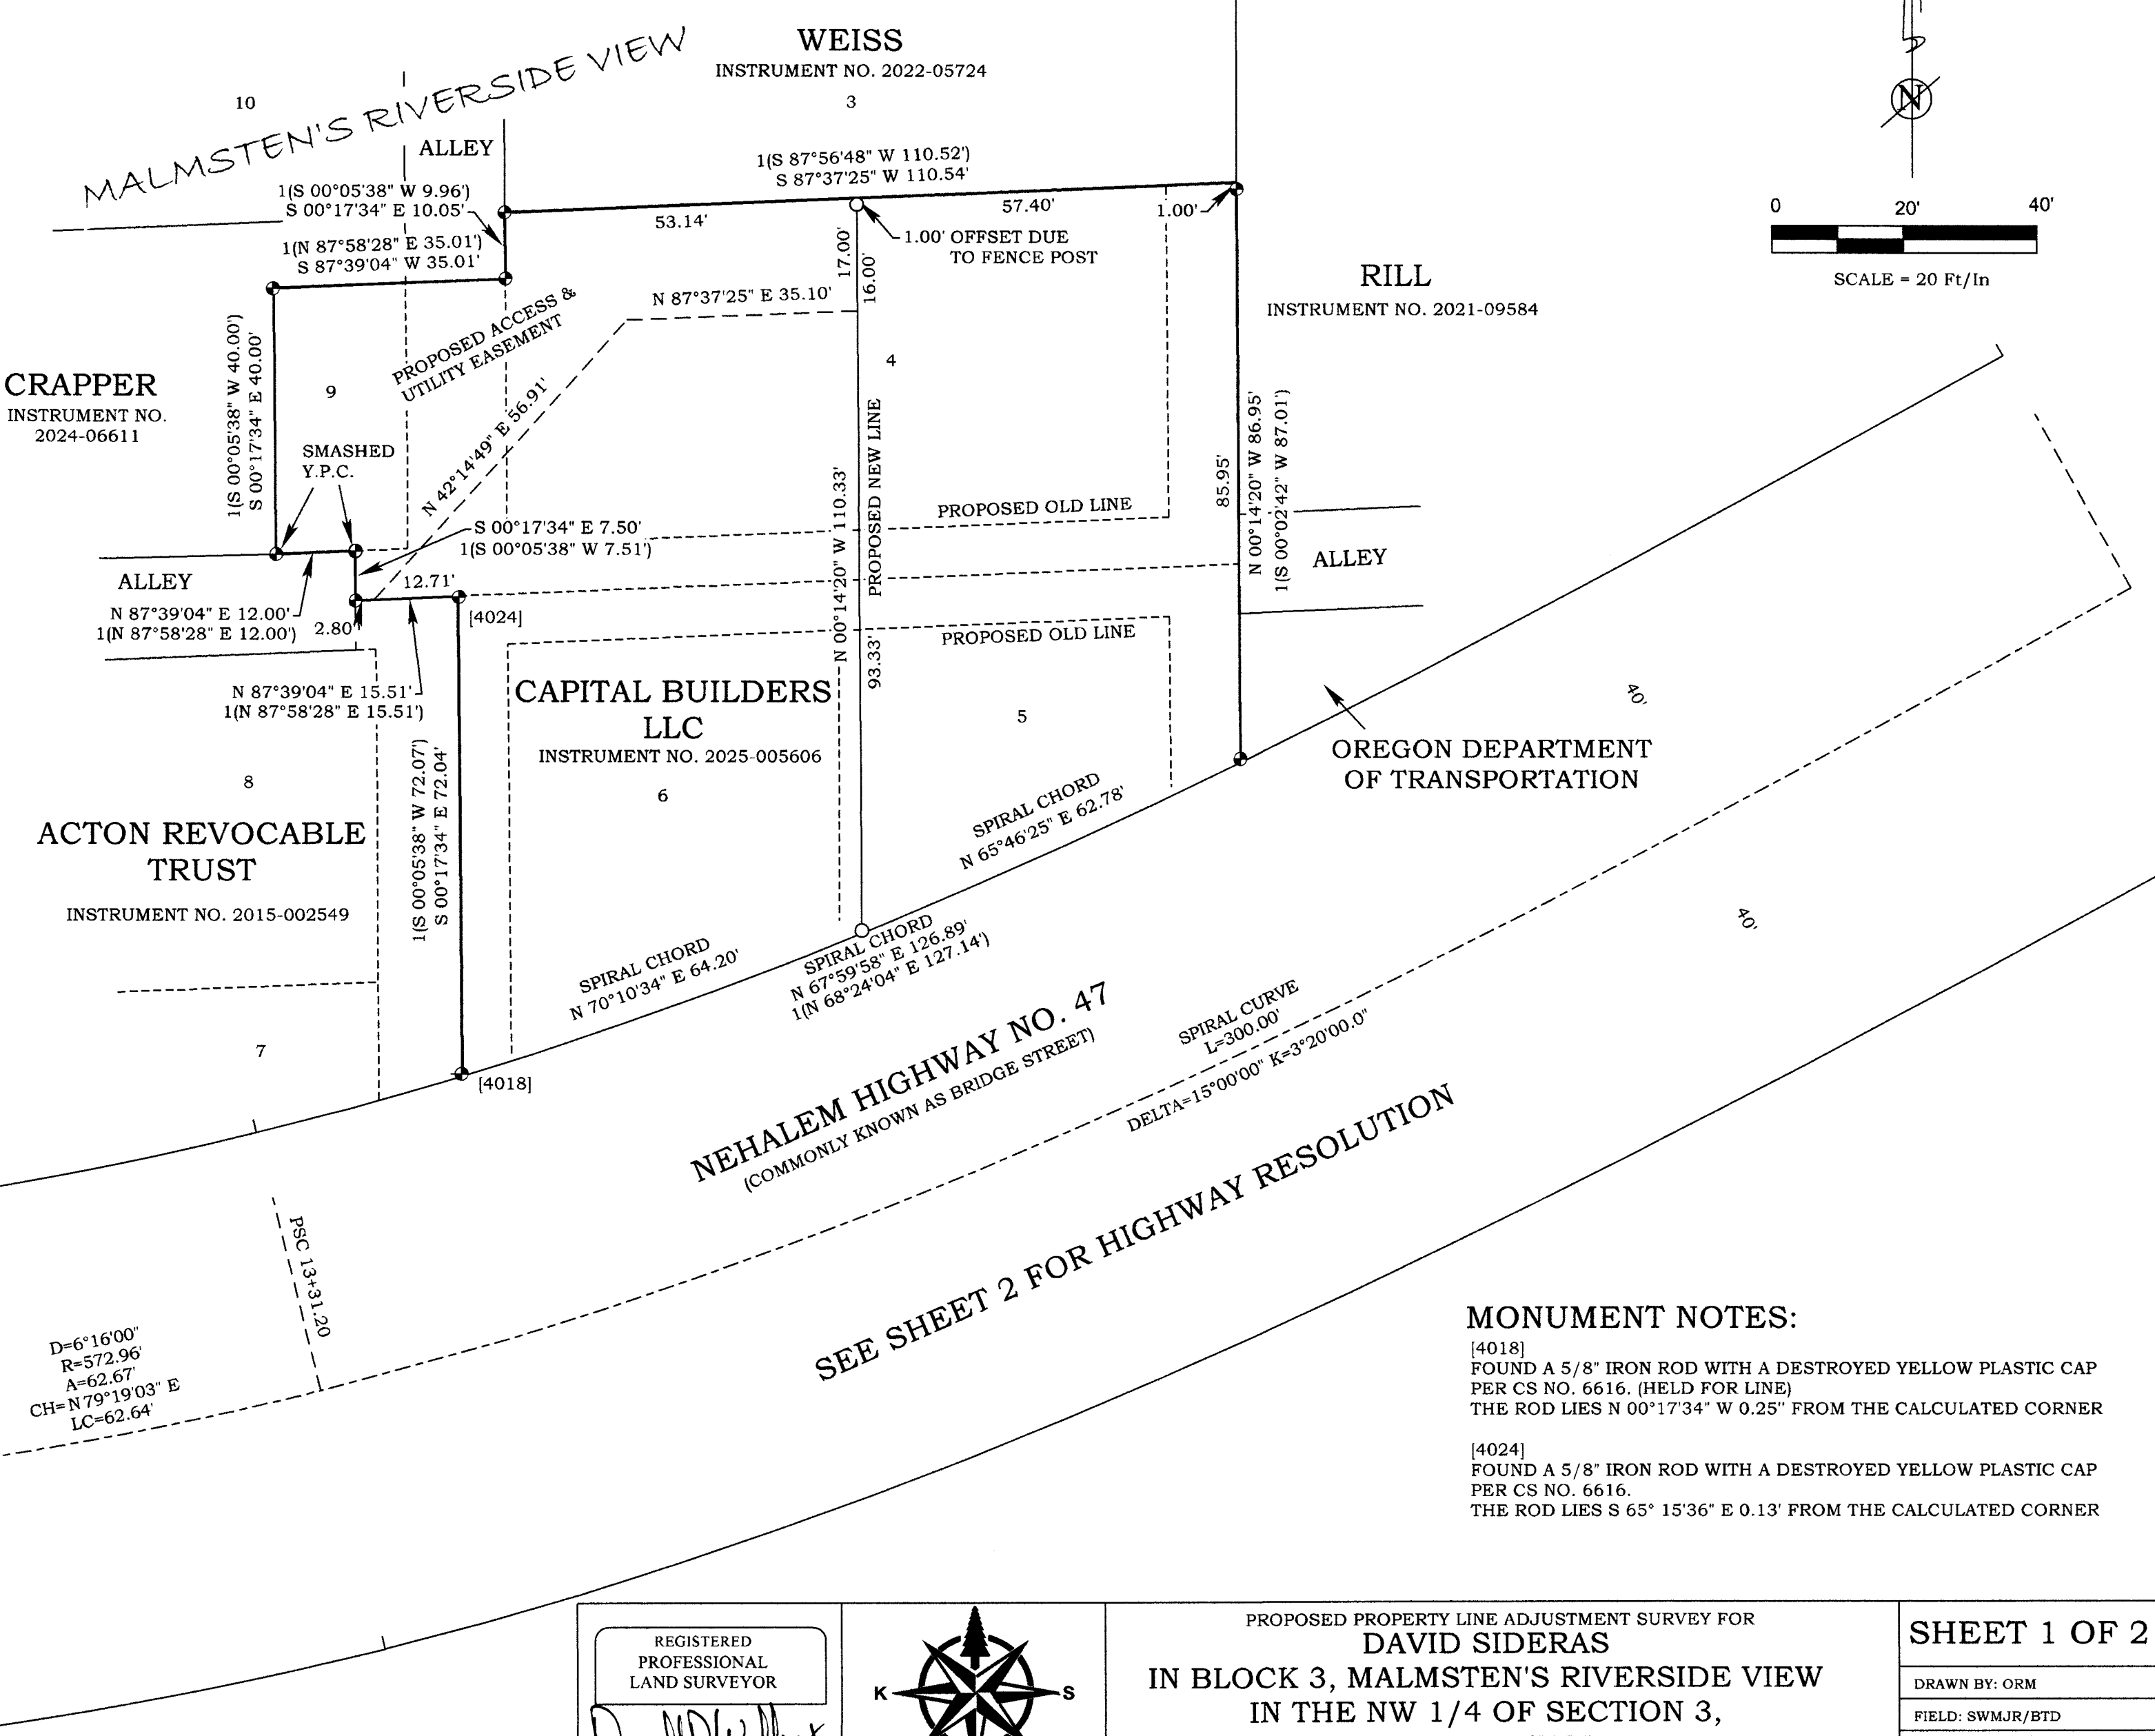

MONUMENT NOTES:

[4018]
FOUND A 5/8" IRON ROD WITH A DESTROYED YELLOW PLASTIC CAP PER CS NO. 6616. (HELD FOR LINE)
THE ROD LIES N 00°17'34" W 0.25' FROM THE CALCULATED CORNER

[4024]
FOUND A 5/8" IRON ROD WITH A DESTROYED YELLOW PLASTIC CAP PER CS NO. 6616.
THE ROD LIES S 65° 15'36" E 0.13' FROM THE CALCULATED CORNER

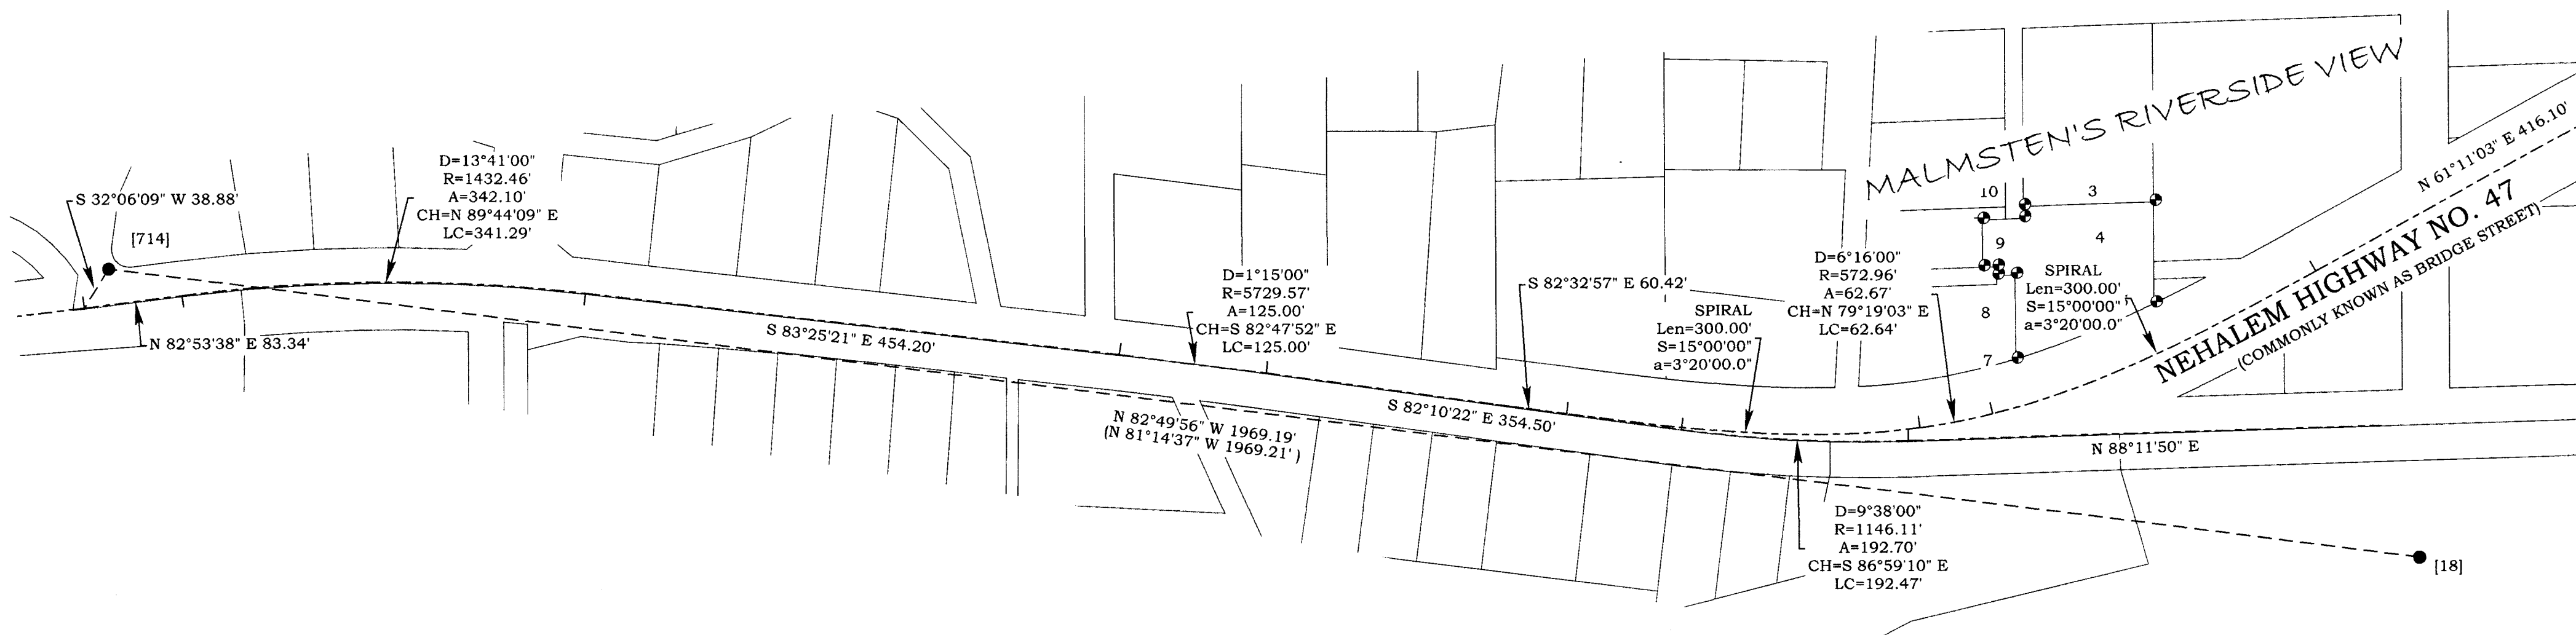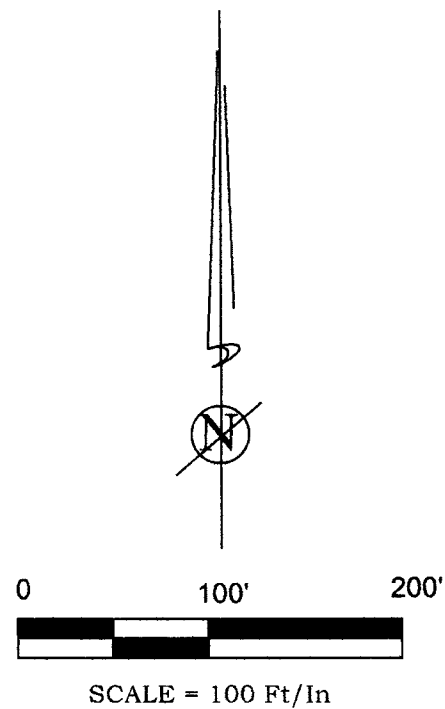

REFERENCES:

- SURVEYS
1 = CS NO. 6616
2 = MALMSTEN'S RIVERSIDE VIEW
- DEEDS
1 = INSTRUMENT NO. 2015-002549
2 = INSTRUMENT NO. 2021-09584
3 = INSTRUMENT NO. 2022-05724
4 = INSTRUMENT NO. 2024-06611
5 = INSTRUMENT NO. 2025-005606

LEGEND

- FOUND MONUMENT AS NOTED
- ⊕ FOUND A 5/8" IRON ROD WITH A Y.P.C. MARKED "S.W.L.S. INC 503-665-7777" PER CS NO. 6616, (HELD), UNLESS OTHERWISE NOTED
- SET A 5/8" X 30" IRON ROD WITH A Y.P.C. MARKED "KLS SURVEYING INC."
- [X] MONUMENT POINT NO
- () RECORD SURVEY DATA
- [] RECORD DEED DATA
- CS NO. SURVEY NUMBER, COLUMBIA COUNTY SURVEY RECORDS
- Y.P.C. YELLOW PLASTIC CAP
- S.F. SQUARE FEET

MONUMENT NOTES:

- [18]
COLUMBIA 02
FOUND A 3/4" IRON PIPE WITH A 2 1/2" BRASS CAP PER CS NO. 4369
- [714]
SW CORNER OF LOT 1, BLOCK 5, OREGON AMERICAN SUBDIVISION
FOUND A 1/2" IRON PIPE PER OREGON AMERICA SUBDIVISION. THE PIPE LIES AT STATION 25+35.25 AND LEFT 30.12'.

REGISTERED
PROFESSIONAL
LAND SURVEYOR

Donald D Wallace, Jr.

OREGON
JANUARY 19, 1993
DONALD D WALLACE, JR
2601

RENEWS 6/30/26



PROPOSED PROPERTY LINE ADJUSTMENT SURVEY FOR
DAVID SIDERAS
IN BLOCK 3, MALMSTEN'S RIVERSIDE VIEW
IN THE NW 1/4 OF SECTION 3,
T4N, R4W, W.M.,
CITY OF VERNONIA,
COLUMBIA COUNTY, OREGON
MARCH 26, 2026

SHEET 2 OF 2

DRAWN BY: ORM

FIELD: SWMJR/BTD

EQUIPMENT: NOMAD/NIKON

JOB No. OOCRS VERNONIA

DRAWING NAME: 25-257 PLA ROS

REVISED: 4-30-2026